


Labor and Materials

Copper } Connection.....	\$.....
Lead }	\$.....
Curb { Cock Valve T.S.&V. }	in \$.....
Service Box { Short 3½x4½ }	\$.....
Old returned { Long 4½x5½ }	\$.....
	Buff. or Rdway }
Ft..... in. { Copper } Pipe at	\$.....
	{ Galv. Iron }
	{ Cast Iron }
Nipples	in. at \$.....
Bushings	to in. at \$.....
Red'g } Couplings.....	to in. at \$.....
Inc'g }
Union.....	in. at \$.....
Meter.....	in. at \$.....
Lbs. Br. Stone at	\$.....
Lbs. Sand at	\$.....
Bags Cement at	\$.....
Paving Brick { Mack } at	\$.....
	{ Red }
	{ Asphalt }
Lead Joints at	\$.....
Leadite Joints at	\$.....
Hrs. Foreman at	\$.....
Hrs. Common Labor at	\$.....
Hrs. Common Labor at	\$.....
Hrs. Mason at	\$.....
Hrs. Masons Helper at	\$.....
Hrs. Compressor at	\$.....
Compensation Ins	\$.....
Trucking	\$.....
Builders Use of Water	\$.....
Total \$.....	

Labor and Material Report *Sept 2* 1933

Shut off for Bucking on Sherman Ave.

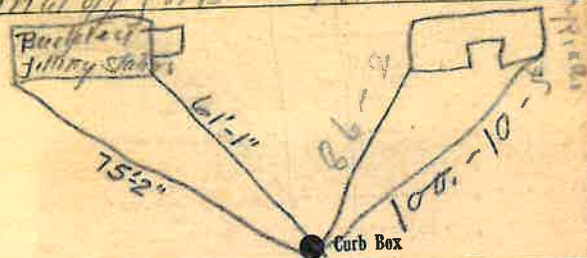

Main Elev. of Main at tap _____

Gate at ● ● Gate at _____

● Curb Box

By Person

[Signature]