

LABOR AND MATERIALS


Copper	Lead	Connection	6x4 Teeing	\$	
			Sleeve + Valve		
1	Curb	Cock Valve	6x4 in.	\$	
		T. S. & V.			
1	Service Box	Short 3 1/2 x 4 1/2		\$	
	Old returned	Long 4 1/2 x 5 1/2			
		Buff. or Rdway			
37	Ft.	4 in.	Copper Galv Iron Cast Iron	Pipe at	\$
	Nipples	in. at			\$
	Bushings	to in. at			\$
	Red'g Inc'g	Couplings	to in. at		\$
1	Union	4 in. at	Plug		\$
1	Welder	4 in. at	1 1/4 Bend		\$
	Lead Joints	at			\$
	Leadite Joints	at			\$
	Hrs. Foreman	at			\$
	Hrs. Chauffeur	at			\$
	Hrs. Tapper	at			\$
	Hrs. Labor	at			\$
	Hrs. Labor	at			\$
	Hrs. Compressor	at			\$
	Compensation Ins.				\$
	Trucking				\$
	Builders Use of Water				\$
	Tap by Miller & Hassell				\$
					\$
					\$
					\$
					\$

150 - 1938

St. _____
 Pl. _____
 Ave. No. _____

Name of Owner
 G. F. Dept Sewer

Labor and Mat'l. Report Sept 22 1938

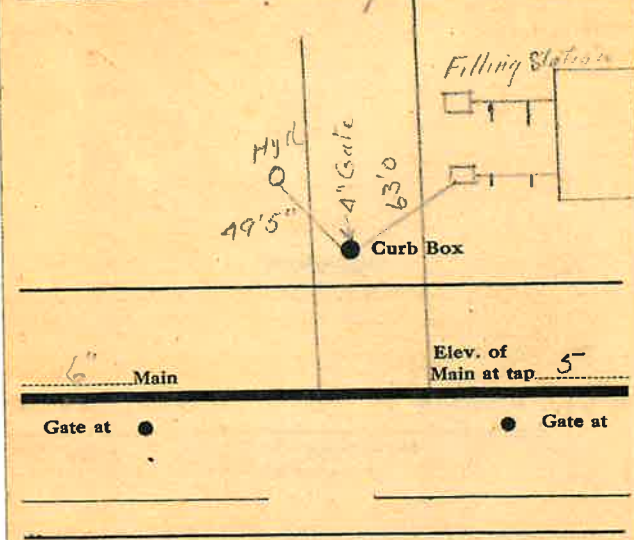

● Curb Box

New 4" Tap

37' 4" - CAST IRON