

Labor and Materials


Copper	Connection	\$
Lead		\$
Curb	Cock Valve T. S. & V. in.	\$
Service Box	Short 3 1/2 x 4 1/2	\$
Old returned	Long 4 1/2 x 5 1/2		
	Buff. or Rdway		
5 Ft.	5 3/4 in.	Copper Pipe at	\$
		Cast Iron	\$
Nipples in. at	\$
Bushings to in. at	\$
Red'g Inc'g	Couplings to in. at	\$
Union in. at	\$
Meter in. at	\$
Lbs. Br. Stone	at	\$
Lbs. Sand	at	\$
Bags Cement	at	\$
Paving Brick	Mack Red Asphalt	} at	\$
Lead Joints	at	\$
Leadite Joints	at	\$
Hrs. Foreman	at	\$
Hrs. Common Labor	at	\$
Hrs. Common Labor	at	\$
Hrs. Mason	at	\$
Hrs. Mason's Helper	at	\$
Hrs. Compressor	at	\$
Compensation Ins.	\$
Trucking	\$
Builders' Use of Water	\$

from curb box
copper go from 3 1/2" to curb box
to 6" to main. go down

Labor and Material Report

July 14 1922

16 Shippey

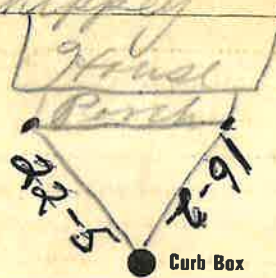

6" Main

Elev. of Main at tap 6'11"

Gate at

5'5" to main

Gate at

3/4" copper

Curb Box

TAX ID# 302.19-25-9