


LABOR AND MATERIALS

1 Copper } Connection  $\frac{3}{4}$ " \$  
 lead }  
 1 Curb } Cock }  $\frac{3}{4}$ " in. OR SEAL \$  
 Valve }  
 T.S. & V. }  
 1 Service box } Short  $3\frac{1}{2}$  x  $4\frac{1}{2}$  } 4' x 5' \$  
 Old returned } Long  $4\frac{1}{2}$  x  $5\frac{1}{2}$  }  
 Buft. or Rdway }  
 11 Ft.  $\frac{3}{4}$  in. } Copper } Pipe at \$  
 C.I. }  
 C.I. }  
 Nipples in. at \$  
 Bushings to in. at \$  
 Red'g }  
 Inc'g } Coupl'gs. to in. at \$  
 Union in. at \$  
 Meter in. at \$  
 Lead Joints at \$  
 Compound Joints at \$  
 Maintenance Foreman \$  
 Hrs. Water Maint. Man-1 at \$  
 Hrs. Water Maint. Man-2 at \$  
 Hrs. Garage Foreman at \$  
 Hrs. Labor at \$  
 Hrs. Compressor at \$  
 Compensation Ins. at \$ per C \$  
 Trucking \$  
 Pav't Patch \$  
 Tap made By Peck & Co \$  
 Oct. 18. 1921 \$  
 O'head \$  
 \$

Shippey St. Ave. No. 18

Name of Owner FRANCIS ARTIBIE

Labor and Mat'l. Report Oct 18 1921

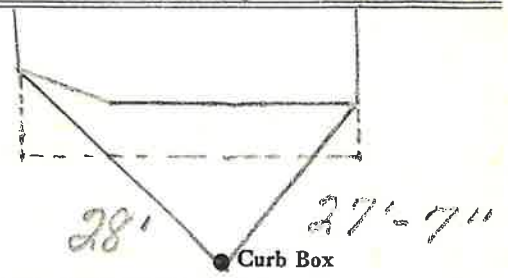

6" Main Elev. of Main at tap 4 1/2"

Gate at • • Gate at

11' to main

3/4" copper • Curb Box

TAX ID # 302.19-25-10