


### LABOR AND MATERIALS

Copper Lead	Connection	3/4	\$ 2.87
Curb	Cock Valve	3/4 in.	\$ 3.62
	P. S. & V.		
Service box	Short 3 1/2 X 4 1/2	Same —	
Old returned	Long 4 1/2 X 5 1/2		
	Buff or Rdway		
17 Ft. 3/4 in.	Copper G.I. Pipe at	37	\$ 5.44
Nipples	in. at		\$
Bushings	to in. at		\$
Red'g Inc'g	Coupl'gs. to in. at		\$
Union	in. at		\$
Meter	in. at		\$
Lead Joints	at		\$
Compound Joints	at		\$
Hrs. Water Maint. Man—1	at		\$
Hrs. Water Maint. Man—2	at		\$
Hrs. Labor—	at		\$
Hrs. Labor—	at		\$
Hrs. Compressor	at		\$
Compensation Ins.	at \$ per C		\$
Trucking			\$
Pav't Patch			\$
<i>Top 4 M. P. 1000</i>			\$
O'head			\$
			\$ 11.93

St. Shippy  
 Pl. 22  
 Ave. No. 22

Name of Owner  
Mrs Rose H. Kinnmouth

Labor and Mat'l. Report June 17 1949

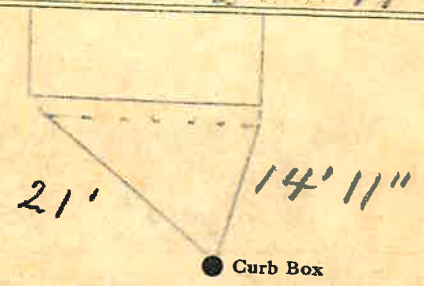

6 Main                      Elev. of Main at tap 5'  
 Gate at ●                      ● Gate at

17' to main  
3/4" copper  
 ● Curb Box

TAX ID # 302.19-25-12

*To be Charge to Shippy St  
 EXT*