


LABOR AND MATERIALS

1 Copper } Connection ^{3/4"} \$ _____
 Lead }
 1 Curb } Cock } ^{3/4" oriseal} \$ _____
 Valve }
 T.S. & V. }
 1 Service box } Short 3 1/2 x 4 1/2 }
 Old returned } Long 4 1/2 x 5 1/2 } \$ _____
 Buff or Rdway }
 22 Ft. ^{3/4} in. } Copper } Pipe at \$ _____
 } G.I. }
 } G.I. }
 Nipples _____ in. at \$ _____
 Bushings _____ to _____ in. at \$ _____
 Red'g }
 Inc'g } Coupl'gs _____ to _____ in. at \$ _____
 Union _____ in. at \$ _____
 Meter _____ in. at \$ _____
 Lead Joints at \$ _____
 Compound Joints at \$ _____
 Maintenance Foreman \$ _____
 Hrs. Water Maint. Man—1 at \$ _____
 Hrs. Water Maint. Man—2 at \$ _____
 Hrs. Garage Foreman _____ at \$ _____
 Hrs. Labor _____ at \$ _____
 Hrs. Compressor at \$ _____
 Compensation Ins. at \$ _____ per C \$ _____
 Trucking \$ _____
 Pav't Patch \$ _____
 Tap by Gifford + Co. \$ _____
 4-21-64. \$ _____
 O'head \$ _____
 \$ _____

St. Shippy
 Pl. 24
 Ave. No. 24

Name of Owner
Michael Carusone

Labor and Mat'l. Report Apr. 21 1964.

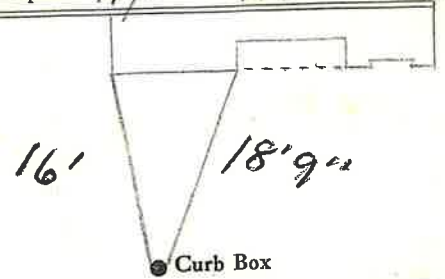

6" C.I. Main Elev. of Main at tap 5'

Gate at • Gate at •

22' to main
3/4" copper
 • Curb Box

Curb box in lawn
 inside of walk.

TAX ID # 302.19-25-13.