

LABOR AND MATERIALS


1	Copper	} Connection	3/4"	\$	
	Lead				
1	Curb	} Cock Valve	3/4 in.	\$	
					T.S. & V.
1	Service box	} Short 3 1/2 x 4 1/2		\$	
	- Old returned				Long 4 1/2 x 5 1/2
					Buff or Rdway
15	3/4 in.	} Copper	} Pipe at	\$	
					G.I.
					G.I.
	Nipples	in. at	\$		
	Bushings	to in. at	\$		
	Red'g	} Coupl'gs	to in. at	\$	
	Inc'g				
	Union	in. at	\$		
	Meter	in. at	\$		
	Lead Joints	at	\$		
	Compound Joints	at	\$		
	Maintenance Foreman		\$		
	Hrs. Water Maint. Man-1	at	\$		
	Hrs. Water Maint. Man-2	at	\$		
	Hrs. Garage Foreman	at	\$		
	Hrs. Labor	at	\$		
	Hrs. Compressor	at	\$		
	Compensation Ins. at \$	per C	\$		
	Trucking		\$		
	Pav't Patch		\$		
	Tap by G. L. S. Ford		\$		
	1801. 6-24-59		\$		
	O'head		\$		
			\$		

✓

St. Shippey Ave. No. 25
Pl.

Name of Owner Erving Smith.

Labor and Mat'l. Report June 24 1959

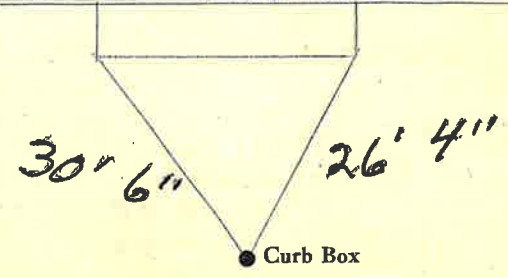

6" Main Elev. of Main at tap 5'
Gate at • Gate at

15' to MAIN

3/4" COPPER • Curb Box
TAX ID # 302.19-21-11