


LABOR AND MATERIALS

1	Copper	} Connection ^{3/4"}	\$
1	Lead		\$
1	Curb	} Cock Valve } ^{3/4} in. <i>or 1 seat</i>	\$
			T.S. & V.
1	Service box	} Short 3 1/2 x 4 1/2 }	\$
Old returned			Long 4 1/2 x 5 1/2 }
		Buff or Rdway	\$
23	Ft. ^{3/4} in.	} Copper } Pipe at	\$
			C.I.
	Nipples	in. at	\$
	Bushings	to in. at	\$
	Red'g } Inc'g }	Coupl'gs. to in. at	\$
	Union	in. at	\$
	Meter	in. at	\$
	Lead Joints at		\$
	Compound Joints at		\$
	Maintenance Foreman		\$
	Hrs. Water Maint. Man-1 at		\$
	Hrs. Water Maint. Man-2 at		\$
	Hrs. Garage Foreman at		\$
	Hrs. Labor— at		\$
	Hrs. Compressor at		\$
	Compensation Ins. at \$	per C.	\$
	Trucking		\$
	Pav't Patch		\$
	Tap by Gifford & Co.		\$
	3-7-66.		\$
	O'head		\$

Shippey St. ~~Pl.~~
Ave. No. 28

Name of Owner
Frank Collins.

Labor and Mat'l. Report Mar. 7 1966.

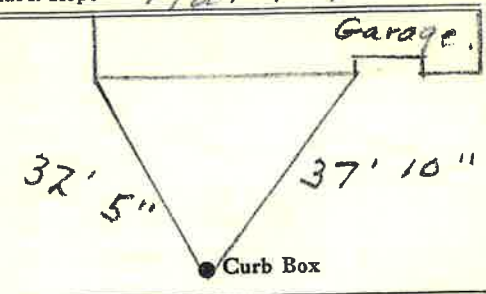

6" Main Elev. of Main at tap 5 1/2'

Gate at • • Gate at

23' to main

3/4" Copper • Curb Box

TAX ID# 302.19-24-1