


LABOR AND MATERIALS

Copper	} Connection	_____	\$ _____	
Lead				
Curb	} Cock	_____ in.	\$ _____	
				} Valve
Service box	} Short 3½ x 4½	_____	\$ _____	
				} Long 4½ x 5½
Ft. _____ in.	} Copper	} Pipe at _____	\$ _____	
				} G. I.
Nipples _____ in.	at _____	\$ _____		
Bushings _____ to _____ in.	at _____	\$ _____		
Red'g } Inc'g	} Coupl'gs _____ to _____ in.	at _____	\$ _____	
Union _____ in.				
Meter _____ in.	at _____	\$ _____		
Lead Joints	at _____	\$ _____		
Compound Joints	at _____	\$ _____		
Maintenance Foreman	_____	\$ _____		
Hrs. Water Maint. Man—1	at _____	\$ _____		
Hrs. Water Maint. Man—2	at _____	\$ _____		
Hrs. Garage Foreman	at _____	\$ _____		
Hrs. Labor— _____	at _____	\$ _____		
Hrs. Compressor	at _____	\$ _____		
Compensation Ins. at \$ _____	per C _____	\$ _____		
Trucking	_____	\$ _____		
Pav't Patch	_____	\$ _____		
_____	_____	\$ _____		
_____	_____	\$ _____		
O'head	_____	\$ _____		
_____	_____	\$ _____		

Shippey St. Pl. Ave. No. 6

Name of Owner
TAX ID # 302.19-25-4

Measurements from Sanborn Map
Labor and Mat'l Report Aug. 13 1970

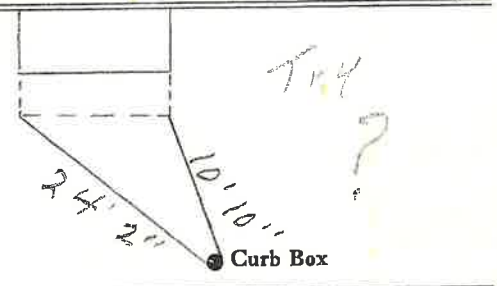

6" Main Elev. of Main at tap 5-7'

Gate at • Gate at •

