

### LABOR AND MATERIALS


1 Copper Lead	{ Connection	3/4"	\$ 2.76
1 Curb	{ Cock Valve T. S. & V. }	3/4" in.	\$ 3.49
1 Service box	{ Short 3 1/2 X 4 1/2 Long 4 1/2 X 5 1/2 Buff or Rdway }		\$ 4.74
14 Old returned	{		
11 Ft.	{ Copper C.I. C.I. }	3/4" in. Pipe at 35	\$ 3.85
1 Nipples	3/4" in. at	male adapter	\$
Bushings	to in. at		\$
Red'g			\$
Inc'g	Coupl'gs to in. at		\$
Union	in. at		\$
Meter	in. at		\$
Lead Joints	at		\$
Compound Joints	at		\$
Hrs. Water Maint. Man-1	at		\$
1 1/2 Hrs. Water Maint. Man-2	at	24	\$ 1.86 1/2
1 1/2 Hrs. Labor	at	13	\$ 1.69 1/2
Hrs. Labor	at		\$
Hrs. Compressor	at		\$
Compensation Ins.	at \$ 3.706 per C.		\$ .13
Trucking			\$ 1.00
Pav't Patch			\$
Tap by Dressoid			\$
7-21-52			\$
O'head			\$
			\$ 19.52

St. 39 ✓  
~~St.~~  
 Ave. No. 26

Shippey

Name of Owner Gleason

Labor and Mat'l. Report July 21 1952

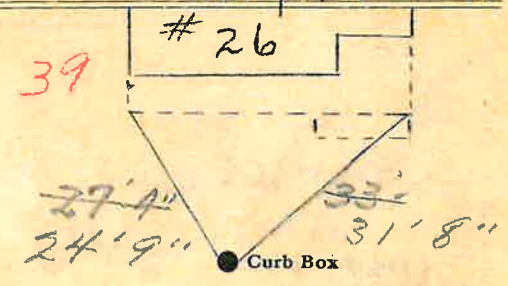

6" Main Elev. of Main at tap 4 1/2

Gate at ● Gate at

14' to main  
3/4" copper

● Curb Box

Extended curb box in 3' - 10 - 27 - 60. used their pipe.

TAX ID# 302.19-15-29

LSM 5C 5 15-48