

1" to 3/4" Coupling - 1 Male Adapter

LABOR AND MATERIALS


- 1 Copper Lead } Connection 3/4" No E / Down
- 1 Curb } Cock Valve } 3/4" in. (orig seal)
- 1 Service box } Short 3 1/2 x 4 1/2
- Old returned } Long 4 1/2 x 5 1/2
- } Buff. or Rdway } _____ \$ _____
- 4 Ft. 3/4" in. } Copper } Pipe at _____ \$ _____
- } ~~C.I.~~ } _____ \$ _____
- } ~~C.I.~~ } _____ \$ _____
- _____ Nipples _____ in. at _____ \$ _____
- _____ Bushings _____ to _____ in. at _____ \$ _____
- _____ Red'g } _____
- _____ Inc'g } Coupl'gs _____ to _____ in. at _____ \$ _____
- _____ Union _____ in. at _____ \$ _____
- 1 Meter 3/4" in. at Male Adapter _____ \$ _____
- _____ Lead Joints at _____ \$ _____
- _____ Compound Joints at _____ \$ _____
- _____ Maintenance Foreman _____ \$ _____
- _____ Hrs. Water Maint. Man-1 at _____ \$ _____
- _____ Hrs. Water Maint. Man-2 at _____ \$ _____
- _____ Hrs. Garage Foreman _____ at _____ \$ _____
- _____ Hrs. Labor _____ at _____ \$ _____
- _____ Hrs. Compressor at _____ \$ _____
- _____ Compensation Ins. at \$ _____ per C _____ \$ _____
- _____ Trucking _____ \$ _____
- _____ Pav't Patch _____ \$ _____
- _____ _____ \$ _____
- _____ _____ \$ _____
- _____ _____ \$ _____
- _____ O'head _____ \$ _____

This 6" MAIN IS UNDER SIDEWALK - HOUSE SIDE OF SEWER

Shippey St. No. 8


Name of Owner BARBER

Labor and Mat'l. Report JAN 22 19 74

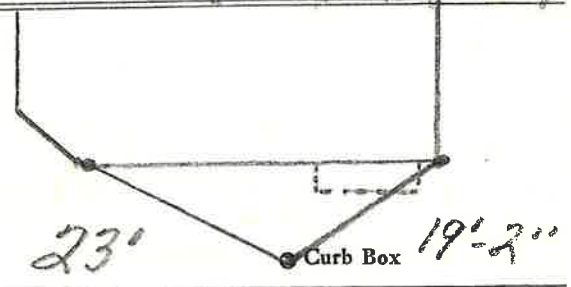

6 Main Elev. of Main at tap 7'

Gate at • Gate at • TAX ID # 302.19-25-5

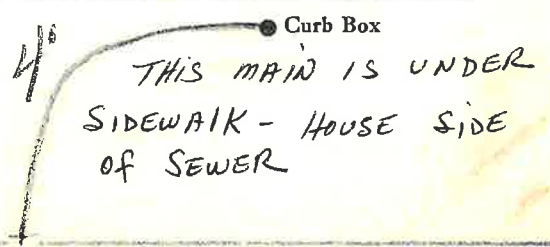

THIS MAIN IS UNDER SIDEWALK - HOUSE SIDE OF SEWER