

LABOR AND MATERIALS


1	Copper Lead	Connection	3/4	\$	2.80
1	Curb	Clock Valve F. S. & V.	3/4 in.	\$	3.60
1	Service box Old returned	Short 3 3/4 X 4 3/4 Long 4 3/4 X 5 3/4 Buff or Rdway		\$	5.80
44	Ft.	3/4 in.	Copper Galv. Iron Cast Iron	Pipe at	35 15.40
	Nipples	in. at		\$	
	Bushings	to in. at		\$	
	Red'g Inc'g	Couplings	to in. at	\$	
	Union	in. at		\$	
	Meter	in. at		\$	
	Lead Joints at			\$	
4	Compound Joints at			\$	
4	Hrs. Foreman at	WMM	9 1/2 hr	\$	3.70
4	Hrs. Chauffeur at		8 1/2 hr	\$	3.30
4	Hrs. Tapper at			\$	
4	Hrs. Labor at		7 1/2 hr	\$	2.90
	Hrs. Labor at			\$	
	Hrs. Compressor at			\$	22
	Compensation Ins.			\$	1.00
	Trucking			\$	
	Builders Use of Water			\$	
	Tap by Miller & Worsinski				\$
	This main is under				\$
	8' x 12' Well				\$
				\$	38.72

35-47

St. Pl. Ave. No. 9

Shippy Barber
Name of Owner

Labor and Mar'l. Report June 22 1947

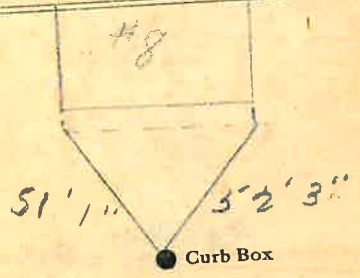

TAX ID # 302.19-22-19
6 Main Elev. of Main at tap 7
Gate at ● Gate at ●

44' to main
3/4" copper

● Curb Box
This Tap for Vacant Lot Measured from #8 for #9

LSM-SC-6-1-45 MAIN UNDER SIDEWALK