

Labor and Material Report *Sept 26 1922*

*Shippy at McLinn's Box
7+6!!
No Measurement*

● Curb Box

6" Main

Elev. of Main at tap

Gate at ●

● Gate at

29' to MAIN

3/4" Gal.

● Curb Box


36-47
✓
Shippy

St. *11*
Pl. *11*
Ave. No. *11*

Name of Owner

Barber's Market

*New Bld'g Measured in
9-3-59
Labor and Mat'l. Report + June 24 1947*

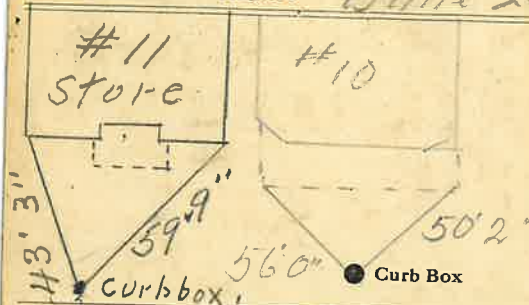

6" Main

Elev. of Main at tap *5*

Gate at ●

● Gate at

*37' to MAIN
3/4" Copper*

● Curb Box

*Lot tap Measured
from #10 for #11*

LSM-5C-6-1-45

MAIN IS UNDER SIDEWALK

Labor and Materials

1	Lead Connection $\frac{1}{2}$ "	\$	
	Curb Cock	\$	
1	Service Box (Short 3 $\frac{1}{2}$ x 4 $\frac{1}{2}$) Old returned (Long 4 $\frac{1}{2}$ x 6 $\frac{1}{2}$) Buffalo	\$	
29	Ft. $\frac{3}{4}$ in. G. I. Pipe at	\$	
	Nipples in. at	\$	
	Bushings in. at	\$	
	Red'g Coup. to in. at	\$	
	Inc'g Coup. to in. at	\$	
	Union in. at	\$	
	Meter in. at	\$	
	Cu. Yds. Br. Stone at	\$	
	Cu. Yds. Sand at	\$	
	Bags Cement at	\$	
	Pav. Brick { Mack Red Asphalt } at	\$	
1	Hrs. Foreman at	\$	
1	Hrs. Com. Labor at	\$	
	Hrs. Mason at	\$	
	Hrs. at	\$	
	Hrs. at	\$	
9m	Builders' Use of Water	\$	
	at	\$	
	Trucks (P.O.)	\$	
	at	\$	
	at	\$	
	at	\$	
	Total	\$	10.71

LABOR AND MATERIALS

1	Copper Lead } Connection $\frac{3}{4}$	\$	2.80
1	Curb { Clock Valve T. S. & V. } $\frac{3}{4}$ in.	\$	3.60
1	Service box Old returned { Short 3 $\frac{1}{2}$ X 4 $\frac{1}{2}$ Long 4 $\frac{1}{2}$ X 5 $\frac{1}{2}$ Buff or Rdway }	\$	5.80
37	Ft. $\frac{3}{4}$ in. { Copper Galv. Iron Cast Iron } Pipe at $\frac{35}{4}$	\$	12.95
	Nipples in. at	\$	
	Bushings to in. at	\$	
	Red'g } Couplings to in. at Inc'g }	\$	
	Union in. at	\$	
	Meter in. at	\$	
	Lead Joints at	\$	
	Compound Joints at	\$	
4	Hrs. Foreman at WMM ①	92h	\$ 3.70
4	Hrs. Chauffeur at WMM ②	82h	\$ 3.30
4	Hrs. Tapper at		\$
4	Hrs. Labor at	71 $\frac{1}{2}$	\$ 2.90
	Hrs. Labor at		\$
	Hrs. Compressor at		\$
	Compensation Ins.		\$ 22
	Trucking		\$ 1.00
	Builders Use of Water		\$
	Topy. M. / 1/2 + WATSKIN		\$
	This main is under		\$
	Circle		\$
	Total		\$ 36.27