

LABOR AND MATERIALS

1	Copper Lead	Connection	3/4"	\$
1	Curb	Cock Valve T.S. & V.	3/4" in.	\$
1	Service box Old returned	Short 3 1/2 x 4 1/2 Long 4 1/2 x 5 1/2 Buff or Rdway		\$
6	Ft.	3/4" in. Copper G.I. C.I.	Pipe at	\$
	Nipples	in. at		\$
	Bushings	to in. at		\$
	Red'g Inc'g	Coupl'gs to in. at		\$
	Union	in. at		\$
	Meter	in. at		\$
	Lead Joints	at		\$
	Compound Joints	at		\$
	Maintenance Foreman			\$
	Hrs. Water Maint. Man	1 at		\$
	Hrs. Water Maint. Man	2 at		\$
	Hrs. Garage Foreman	at		\$
	Hrs. Labor	at		\$
	Hrs. Compressor at			\$
	Compensation Ins. at \$	per C		\$
	Trucking			\$
	Pav't Patch			\$
	Tap by Miller & Co			\$
	7-24-57			\$
	O'head			\$

129-1937

St. Pt. Ave. No. 13


Name of Owner

Clarke

Labor and Mat'l. Report

Scht 24

1937

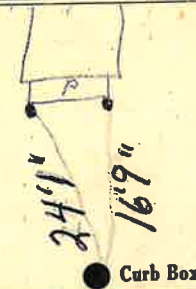

Curb Box

6" Main

Elev. of Main at tap.....

Gate at

Gate at

29' to MAIN
3/4" COPPER

Curb Box

Old tap shut off

SH
Shut off at Curb

MAY-7-1975