


LABOR AND MATERIALS

1	Copper	} Connection	3/4"	\$
	Lead			
1	Curb	} Valve	3/4 in.	\$
1	Service box	} Short 3 1/2 x 4 1/2		\$
	Old returned			
28	Ft. 3/4 in.	} Pipe at		\$
	Nipples	in. at		\$
	Bushings	to in. at		\$
	Red'g	} Coupl'gs	to in. at	\$
	Inc'g			
	Union	in. at		\$
	Meter	in. at		\$
	Lead Joints	at		\$
	Compound Joints	at		\$
	Maintenance Foreman			\$
	Hrs. Water Maint. Man-1	at		\$
	Hrs. Water Maint. Man-2	at		\$
	Hrs. Garage Foreman	at		\$
	Hrs. Labor	at		\$
	Hrs. Compressor	at		\$
	Compensation Ins.	at \$ per C		\$
	Trucking			\$
	Pav't Patch			\$
	Tap by Lareau & Co.			\$
	8-19-70.			\$
	O'head			\$
				\$

St. Shiopey
 Ave. No. 15
 Name of Owner Ray Dargmond
 Labor and Mat'l. Report Aug. 18 - 1970

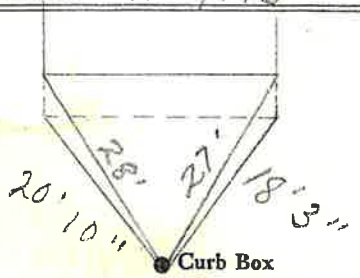

6" Main Elev. of Main at tap 4 1/2'
 Gate at • Gate at
 28' to main
 3/4" copper • Curb Box
 TAX ID # 302.19-22-17