


LABOR AND MATERIALS

1	Copper	Connection	3/4"	\$
1	Lead	Cock	3/4 in. 0-15 gal	\$
1	Curb	Valve	3/4 in.	\$
		T.S. & V.		\$
1	Service box	Short 3 1/2 x 4 1/2	2 x 2 1/2	\$
	Old returned	Long 4 1/2 x 5 1/2		\$
		Buff or Rdway		\$
30	Ft.	Copper	Pipe at	\$
		G.I.		\$
		G.I.		\$
	Nipples	in. at		\$
	Bushings	to in. at		\$
	Red'g }			\$
	Inc'g }	Coupl'gs to in. at		\$
	Union	in. at		\$
	Meter	in. at		\$
	Lead Joints	at		\$
	Compound Joints	at		\$
	Maintenance Foreman			\$
	Hrs. Water Maint. Man-1	at		\$
	Hrs. Water Maint. Man-2	at		\$
	Hrs. Garage Foreman	at		\$
	Hrs. Labor	at		\$
	Hrs. Compressor	at		\$
	Compensation Ins. at \$	per C		\$
	Trucking			\$
	Pav't Patch			\$
	Tap by Gifford			\$
	+ Co.			\$
	O'head	3-2-64		\$

St. Sierra
 Pl. 10
 Ave. No. 10

Name of Owner Mel Garrard.

Labor and Mat'l. Report Mar. 2 1964.

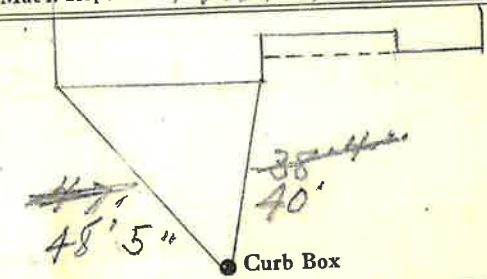

6" Main Elev. of Main at tap 5'

Gate at • Gate at
30' to MAIN

3/4" copper • Curb Box
Tap on Sierra St.
 Tax ID# 303.13-15-2