

LABOR AND MATERIALS


1	Copper	{	Connection	<u>3/4"</u>	\$	3.04
	Lead	{				
1	Curb	{	Cock Valve		\$	3.54
		{	T-S & V			
1	Service box	{	Short $3\frac{1}{2} \times 4\frac{1}{2}$		\$	4.70
	Old returned	{	Long $4\frac{1}{2} \times 5\frac{1}{2}$			
		{	Buff or Rdway			
22	Ft. <u>3/4</u> in.	{	Copper	Pipe at <u>35</u>	\$	7.70
		{	G.I.			
		{	G.I.			
	Nipples	in. at			\$	
	Bushings	to in. at			\$	
	Red'g	{	Coupl'gs	to in. at	\$	
	Inc'g	{				
	Union	in. at			\$	
	Meter	in. at			\$	
	Lead Joints at				\$	
	Compound Joints at				\$	
	Hrs. Water Maint. Man-1 at				\$	
2	Hrs. Water Maint. Man-2 at	<u>1.13</u>			\$	2.26
5	Hrs. Labor— at	<u>1.02</u>			\$	5.10
	Hrs. Labor— at				\$	
	Hrs. Compressor at				\$	
	Compensation Ins. at \$		per C.		\$	20.
	Trucking				\$	<u>1</u>
	Pav't Patch	<u>E 4T Main</u>			\$	
					\$	
					\$	
					\$	
	O'head				\$	

Tap made by Gifford  
 Sept 7-1951  
 \$77.54

St. Pt. Ave. No. 22  
Sierra

Name of Owner Ball

Labor and Mat'l. Report Sept 7 1951

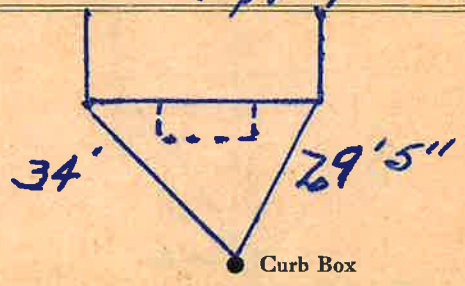

6" Main Elev. of Main at tap 3'

Gate at ● Gate at ●

22' to main

3/4" copper ● Curb Box