


1-1" X 3/4" Sweat 90°
LABOR AND MATERIALS .40

Copper	{ Connection		\$
Lead			\$
1 Curb	{ Gock Valve T.S. & V. } 3/4 in.		\$ 3.54
1 Service box	{ Short 3 1/2 x 4 1/2 } { Long 4 1/2 x 5 1/2 } { Buff or Rdway }		\$ 4.70
11 Ft.	3/4 in. { Copper } { G.I. } { C.I. }	Pipe at 35	\$ 3.85
Nipples	in. at		\$
Bushings	to in. at		\$
Red'g Inc'g	{ Coupl'gs to in. at }		\$
Union	in. at		\$
Meter	in. at		\$
Lead Joints	at		\$
Compound Joints	at		\$
Hrs. Water Maint. Man-1	at		\$
Hrs. Water Maint. Man-2	at		\$
14 Hrs. Labor	at 1.02		\$ 14.28
Hrs. Labor	at		\$
Hrs. Compressor	at		\$
Compensation Ins.	at \$2.66 per C.		\$ 3.8
Trucking			\$ 1.00
Pav't Patch	EXT. of Main		\$
			\$
			\$
			\$
O'head			\$
Tap by Mountain			\$ 28.15
11-21-50			

11-1951
 Sierra
 St. 25
 -Pl-
 Ave. No. 29

Name of Owner
 Ball Lot 203 & 204

Labor and Mat'l. Report 11-21-1950

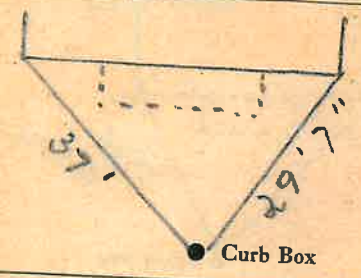

1" Cu. Main
 Elev. of Main at tap 32
 Reference Diagram

Gate at ●
 11' to main
 ● Gate at

3/4" copper ● Curb Box

TAX ID # 303.13-17-4