

LABOR AND MATERIALS


1	Copper Lead	{ Connection	1" x 3/4" Tee	\$ 2.29
1	Curb	{ Cock Valve F.S. & V.	3/4 in.	\$ 2.70
1	Service box Old returned	{ Short 3 1/2 x 4 1/2 Long 4 1/2 x 5 1/2 Buff or Rdway		\$ 4.25
13.5	Ft. 3/4 in.	{ Copper G.I. C.I.	Pipe at 35	\$ 3.95
	Nipples	in. at		\$
	Bushings	to in. at		\$
	Red'g Inc'g	{ Coupl'gs	to in. at	\$
	Union	in. at		\$
	Meter	in. at		\$
	Lead Joints at			\$
	Compound Joints at			\$
	Hrs. Water Maint. Man-1 at			\$
	Hrs. Water Maint. Man-2 at			\$
14	Hrs. Labor	at 91		\$ 12.74
	Hrs. Labor	at		\$
	Hrs. Compressor at			\$
	Compensation Ins. at \$ 2.226 per C.			\$ 2.8
	Trucking			\$ 1.00
	Pay't Patch	cut of Main		\$
	Tap by Moquin			\$
	O'head			\$
				\$ 27.11

195-1950 #31 # 27 ✓  
 St. Lot  
 Ave. No. 205

Name of Owner  
 Ball

Labor and Mat'l. Report Nov 17 19 50

remeasured  
 5/7/80


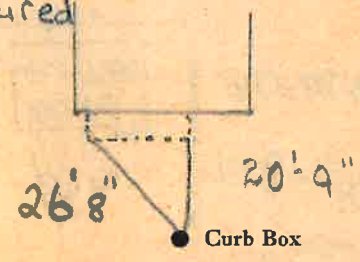


6" Main Elev. of Main at tap 3 1/2'  
 Gate at ● Gate at ●

13 1/2' to main

3/4" copper ● Curb Box

TAX ID # 303.13-7-2

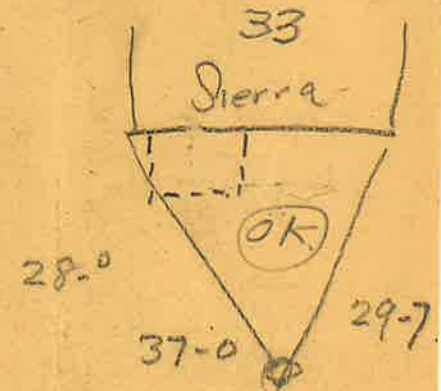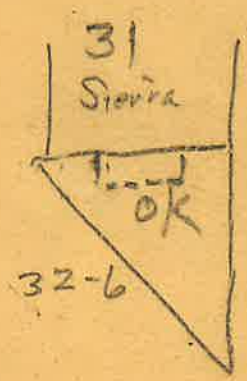

? Check out

31