

LABOR AND MATERIALS

1	Copper Lead	{ Connection	3/4"		\$ 2.29
1	Curb	{ Cock Valve F.S. & V.	3/4" in.		\$ 2.70
1	Service box Old returned	{ Short 3 1/2 x 4 1/2 Long 4 1/2 x 5 1/2 Buff or Rdway			\$ 4.25
13 1/2	Ft. 3/4 in.	{ Copper G.I. C.I.	Pipe at	35	\$ 3.95
	Nipples	in. at			\$
	Bushings	to in. at			\$
	Red'g Inc'g	{ Coupl'gs to in. at			\$
	Union	in. at			\$
	Meter	in. at			\$
	Lead Joints at				\$
	Compound Joints at				\$
	Hrs. Water Maint. Man-1 at				\$
2	Hrs. Water Maint. Man-2 at		1.02		\$ 2.04
9	Hrs. Labor at		91		\$ 72.8
	Hrs. Labor at				\$
	Hrs. Compressor at				\$
	Compensation Ins. at \$ 2.26 per C.				\$ 21
	Trucking				\$ 1.00
	Pav't Patch	6 x 12 Main			\$
	Tap by Narsinski				\$
	O'head				\$
					\$
					\$
					\$ 23.62


#33 #25

Sierra

St. loot
Pt. 207
Ave. No. 207

Name of Owner Ball

Labor and Mat'l. Report Nov. 10 1950

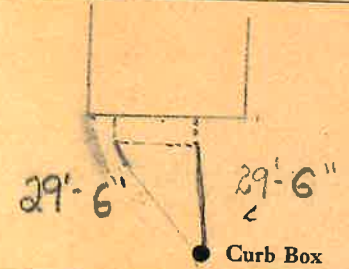

6" Main Elev. of Main at tap 4

Gate at ● ● Gate at

13 1/2' to main

3/4" copper ● Curb Box

TAX ID# 303.13-7-1