

### LABOR AND MATERIALS

Copper } Connection _____	\$ _____
Lead } _____	\$ _____
Curb } Cock _____	in. \$ _____
} Valve _____	\$ _____
} T. S. & V. _____	\$ _____
Service box } Short 3½ x 4½ _____	\$ _____
Old returned } Long 4½ x 5½ _____	\$ _____
} Buff or Rdway _____	\$ _____
Ft. / in. } Copper _____	Pipe at \$ _____
} G. I. _____	\$ _____
} G. P. _____	\$ _____
Nipples _____ in. at _____	\$ _____
Bushings _____ to _____ in. at _____	\$ _____
Red'g } _____	\$ _____
Inc'g } Coupl'gs _____ to _____ in. at _____	\$ _____
Union _____ in. at _____	\$ _____
Meter _____ in. at _____	\$ _____
Lead Joints at _____	\$ _____
Compound Joints at _____	\$ _____
Maintenance Foreman _____	\$ _____
Hrs. Water Maint. Man-1 at _____	\$ _____
Hrs. Water Maint. Man-2 at _____	\$ _____
Hrs. Garage Foreman _____ at _____	\$ _____
Hrs. Labor _____ at _____	\$ _____
Hrs. Compressor at _____	\$ _____
Compensation Ins. at \$ _____ per C _____	\$ _____
Trucking _____	\$ _____
Pav't Patch _____	\$ _____
_____	\$ _____
_____	\$ _____
_____	\$ _____
O'head _____	\$ _____
_____	\$ _____

SIERRA

St. \_\_\_\_\_  
 -Pt. \_\_\_\_\_  
 Ave. No. 37

Name of Owner \_\_\_\_\_

Frederick Palmer

TAX ID # 303.10-2-2

Labor and Mat'l. Report


1986

● Curb Box

Main Elev. of  
Main at tap

Gate at ● ● Gate at

1" COPPER

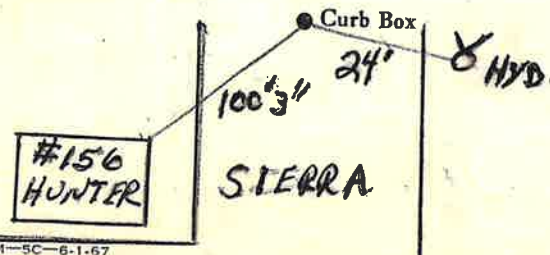

LGM-5C-6-1-67

HUNTER