

LABOR AND MATERIALS


Copper } Connection _____	\$ _____
Lead } _____	\$ _____
Curb } Cock _____	in. \$ _____
} Valve _____	
} T. S. & V. _____	
Service box { Short 3½ x 4½ } _____	\$ _____
Old returned { Long 4½ x 5½ } _____	
} Buff or Rdway _____	
12 Ft. 3/4 in. { Copper } Pipe at _____	\$ _____
} G.I. _____	
} C.I. _____	
Nipples _____ in. at _____	\$ _____
Bushings _____ to _____ in. at _____	\$ _____
Red'g } _____	
Inc'g } Coupl'gs _____ to _____ in. at _____	\$ _____
Union _____ in. at _____	\$ _____
Meter _____ in. at _____	\$ _____
Lead Joints at _____	\$ _____
Compound Joints at _____	\$ _____
Maintenance Foreman _____	\$ _____
Hrs. Water Maint. Man-1 at _____	\$ _____
Hrs. Water Maint. Man-2 at _____	\$ _____
Hrs. Garage Foreman _____ at _____	\$ _____
Hrs. Labor _____ at _____	\$ _____
Hrs. Compressor at _____	\$ _____
Compensation Ins. at \$ _____ per C _____	\$ _____
Trucking _____	\$ _____
Pav't Patch _____	\$ _____
_____	\$ _____
_____	\$ _____
_____	\$ _____
O'head _____	\$ _____
_____	\$ _____

St. _____
Pl. _____
Ave. No. 11

Sienna

Name of Owner _____
Sullivan

Labor and Mat'l. Report _____ 19 87

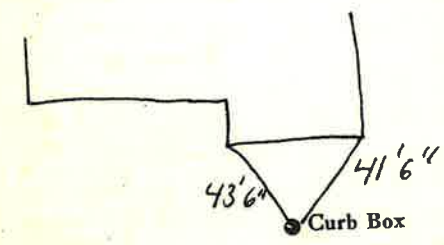

Main Elev. of
Main at tap _____

Gate at • • Gate at _____

12' to main

3/4" COPPER • Curb Box

TAX ID # 303.13-7-10