


LABOR AND MATERIALS

1	Copper	Connection	3/4"	\$	2.76
1	Lead			\$	
1	Curb	Cock Valve	3/4 in.	\$	3.49
		T. S. & V.		\$	
1	Service box	Short 3 1/2 X 4 1/2		\$	
	Old returned	Long 4 1/2 X 5 1/2		\$	4.74
		Buffer Rdway		\$	
14	Ft.	Copper	Pipe at 38	\$	5.32
		G. I.		\$	
		C. I.		\$	
	Nipples	in. at		\$	
	Bushings	to in. at		\$	
	Red'g			\$	
	Inc'g	Coupl'gs to in. at		\$	
	Union	in. at		\$	
	Meter	in. at		\$	
	Lead Joints at			\$	
	Compound Joints at			\$	
	Hrs. Water Maint. Man-1 at			\$	
3	Hrs. Water Maint. Man-2 at	1.24		\$	3.72
1.3	Hrs. Labor	at 1.13		\$	14.69
	Hrs. Labor	at		\$	
	Hrs. Compressor at			\$	
	Compensation Ins. at \$4.406 per C			\$	8.1
	Trucking			\$	1.00
	Pav't Patch			\$	
	Tap by Gifford 10-27-53			\$	
	O'head			\$	
				\$	36.53

93-53
 15?
 St. 13
 Sierra
 Ave. No. 15

Name of Owner
 Ball

Labor and Mat'l. Report Oct. 27 1953

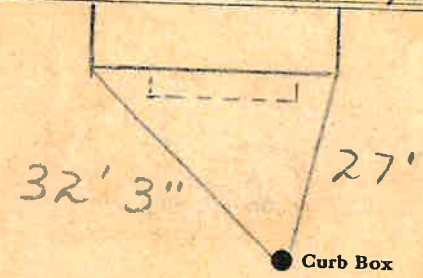

6" Main
 Elev. of Main at tap 3 1/2'

Gate at ● Gate at ●

14' to MAIN

3/4" copper ● Curb Box