

LABOR AND MATERIALS

1	Copper	Connection	3/4"		\$ 2.76	
1	Curb	Cock Valve	3/4" in.		\$ 3.49	
1	Service box	} Short 3 1/2 X 4 1/2 } Long 4 1/2 X 5 1/2 } Buff or Rdway.			\$ 4.74	
	Old returned					
10	Ft. 3/4 in.		Copper Pipe at	38		\$ 3.80
	Nipples	in. at			\$	
	Bushings	to in. at			\$	
	Red'g				\$	
	Inc'g	Coupl'gs to in. at			\$	
	Union	in. at			\$	
	Meter	in. at			\$	
	Lead Joints	at			\$	
	Compound Joints	at			\$	
	Hrs. Water Maint. Man-1	at			\$	
2	Hrs. Water Maint. Man-2	at	1.24		\$ 2.48	
	Hrs. Labor-	at			\$	
	Hrs. Labor-	at			\$	
	Hrs. Compressor	at			\$	
	Compensation Ins.	at \$ 4.406 per C.			\$ 1.04	
	Trucking				\$ 1.00	
	Pay't Patch				\$	
	Tap by GISSORD	7-21-53			\$	
	O'head				\$	

18-31

1953


17? 15

Sierra

St. _____
Pl. _____
Ave. No. 17

Name of Owner _____
Ball

Labor and Mat'l. Report July 21 1953

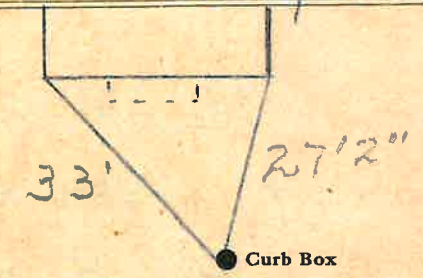

6" Main

Elev. of Main at tap 4'

Gate at ● ● Gate at

10' to MAIN

3/4" COPPER

● Curb Box

TAX ID# 303.13-7-9