

### LABOR AND MATERIALS

1	Copper Lead Connection	3/4"	\$ 2.76
1	Curb Cock Valve T. S. & V.	3/4 in.	\$ 3.49
1	Service box Old returned	Short 3 1/2 X 4 1/2 Long 4 1/2 X 5 1/2 Buff or Rdway	\$ 4.74
26	Ft. 3/4 in. Copper G. I. C. I. Pipe at	35	\$ 9.10
	Nipples	in. at	\$
	Bushings	to in. at	\$
	Red'g Inc'g Coupl'gs	to in. at	\$
	Union	in. at	\$
	Meter	in. at	\$
	Lead Joints at		\$
4	Compound joints at	man 1.44	\$ 5.76
8	Hrs. Water Maint. Man-1 at	1.34	\$ 10.72
3	Hrs. Water Maint. Man-2 at	1.24	\$ 3.72
46	Hrs. Labor- at	1.13	\$ 51.98
	Hrs. Labor- at		\$
1	Hrs. Compressor at	1.50	\$ 6.00
	Compensation Ins. at	\$3.706 per C	\$ 2.67
	Trucking		\$ 1.00
	Pav't Patch		\$
	Top by Gifford	7-31-52	\$
	O'head		\$
			\$ 102.94

Sierra

St. 18  
Ave. No. 18


Name of Owner

Ball

Labor and Mat'l. Report

July 31

1952

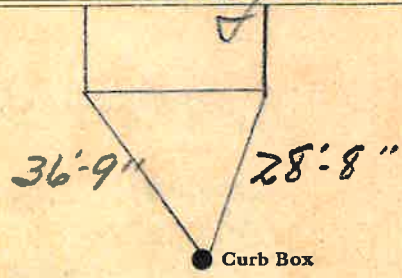

6" Main

Elev. of Main at tap 3'

Gate at ●

● Gate at

26' to MAIN

3/4" COPPER

● Curb Box

TAX ID# 303.13-13-1