

LABOR AND MATERIALS


1	Copper Lead	Connection	3/4"	\$ 2.76
1	Curb	Cock Valve F.S. & V.	3/4 in.	\$ 3.49
1	Service box	Short 3 1/2 x 4 1/2		\$ 4.75
	Old returned	Long 4 1/2 x 5 1/2		
		Buff or Rdway		
12	Ft.	Copper C.I. C.I.	3/4 in. Pipe at 35	\$ 4.20
	Nipples	in. at		\$
	Bushings	to in. at		\$
	Red'g Inc'g	Coupl'gs to in. at		\$
	Union	in. at		\$
	Meter	in. at		\$
	Lead Joints	at		\$
	Compound Joints	at		\$
1	Hrs. Water Maint. Man	1 at		\$ 1.44
2	Hrs. Water Maint. Man	2 at 1.24		\$ 2.48
13	Hrs. Labor	at 1.13		\$ 14.69
	Hrs. Labor	at		\$
	Hrs. Compressor	at		\$
	Compensation Ins.	at \$ 3.706 per C.		\$.69
	Trucking			\$ 1.00
	Pav't Patch			\$
	O'head			\$
	Tap by Gifford			\$ 35.50

4-1-52

Sierra St. Pl. Ave. No. 19

Name of Owner Ball

Labor and Mat'l. Report April-1-1952

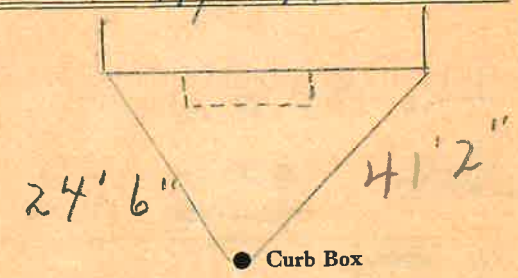

6" Main Elev. of Main at tap 2 1/2"

Gate at • Gate at •
12' to main

3/4" copper • Curb Box

TAX ID# 303.13-7-7