


Labor and Materials

1	Copper	Connection	3	\$ 1.50
1	Curb	Cock Valve T.S. & V.	3	\$ 1.70
1	Service Box Old returned	Short 3 3/4 x 1 1/2 Long 4 1/2 x 5 1/2 Buff. or Railway	4	\$ 1.50
12	2 in.	Copper Cast Iron Cast Iron	Pipe at	\$ 2.28
	Nipples	in. at		\$
	Bushings	to in. at		\$
	Red'g Inc'g	Couplings	to in. at	\$
	Union	in. at		\$
	Meter	in. at		\$
	Lbs. Br. Stone	at		\$
	Lbs. Sand	at		\$
	Bags Cement	at		\$
	Paving Brick	Mack Red Asphalt	at	\$
	Lead Joints	at		\$
	Leadite Joints	at		\$
3	Hrs. Foreman	at 62 in.		\$ 1.88
4	Hrs. Common Labor	at 50		\$ 2.00
8	Hrs. Common Labor	at 45		\$ 3.60
	Hrs. Mason	at		\$
	Hrs. Masons Helper	at		\$
	Hrs. Compressor	at		\$
	Compensation Ins			\$ 0.27
	Trucking			\$ 1.00
	Builders Use of Water	Part Patch		\$ 5.00
Total				\$ 20.77

45 34 21
Labor and Material Report July 11 1934

15 Smith St

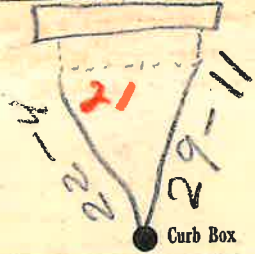

4 Main Elev. of Main at tap 5

Gate at 12' to main
3/4" copper

old tap shut off at main

TAX ID # 302.16-6-18

[Handwritten signature]

VM