


### Labor and Materials

1	Copper } Connection $\frac{3}{4}$ "	\$ 320
	Lead	
1	Curb } Cock Valve } $\frac{3}{4}$ " in.	\$ 100
1	Service Box } Short $3\frac{1}{2} \times 4\frac{1}{2}$	\$ 130
	Old returned } Long $4\frac{1}{2} \times 5\frac{1}{2}$	
22	Ft. $\frac{3}{4}$ " in. } Copper Galv. Iron } Pipe at	\$ 506
	Nipples.....in. at.....	\$
	Bushings.....to.....in. at.....	\$
	Red'g } Couplings $\frac{3}{4}$ " Brass	\$ 15
	Inc'g }	
	Union.....in. at.....	\$
	Meter.....in. at.....	\$
	Lbs. Br. Stone at.....	\$
	Lbs. Sand at.....	\$
	Bags Cement at.....	\$
	Paving Brick } Mack Red Asphalt } at.....	\$
	Lead Joints at.....	\$
	Leadite Joints at.....	\$
9	Hrs. Foreman at..... 62.5	\$ 563
4	Hrs. Common Labor at..... 50	\$ 200
5	Hrs. Common Labor at..... 90.5	\$ 203
	Hrs. Mason at.....	\$
	Hrs. Mason's Helper at.....	\$
	Hrs. Compressor at.....	\$
	Compensation Ins.....	\$ 26
	Trucking.....	\$ 1.00
	Builders' Use of Water.....	\$

Total 2163

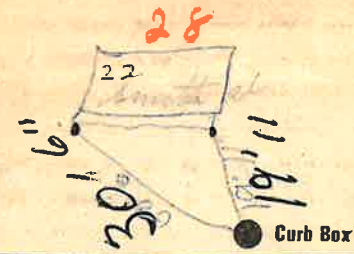

Main Elev. of Main at tap 44

Gate at 23' to main  
3/4" copper  
Curb Box

Bed concrete set off

TAX ID # 302.116-5-12