


Labor and Materials

1	Copper } Connection	3/4	\$
	Lead		
1	Curb { Cock Valve } T. S. & V.	3/4 in	\$
1	Service Box } Old returned { Short 3 1/2 x 4 1/2 Long 4 1/2 x 5 1/2 Buff. or Rdway }		\$
23	Pt. } in. { Copper Galv. Iron Cast Iron }	Pipe at	\$
	Nipples	in. at	\$
	Bushings	to.....in. at	\$
1	Rad. } Couplings	3/4 to.....in. at	\$
	Union	in. at	\$
	Meter	in. at	\$
	Lbs. Br. Stone	at	\$
	Lbs. Sand	at	\$
	Bags Cement	at	\$
	Paving Brick { Mack Red Asphalt }	at	\$
	Lead Joints	at	\$
	Leadite Joints	at	\$
3	Hrs. Foreman	at	\$
16	Hrs. Common Labor	at	\$
	Hrs. Common Labor	at	\$
	Hrs. Mason	at	\$
	Hrs. Mason's Helper	at	\$
	Hrs. Compressor	at	\$
	Compensation Ins.	at	\$
1/2	Trucking	at	\$
200	Builders' Use of Water	at	\$
Total			\$ 1708

Labor and Material Report No. 230 1925

no 8 Smith st

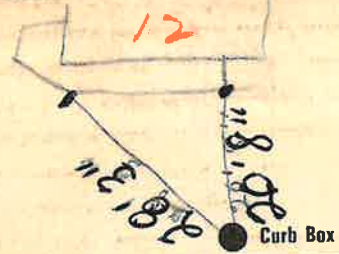

4" Main

Elev. of Main at tap 5'

Gate at 23' to main

Gate at

3/4" copper Curb Box

TAX ID # 302.16-5-4