

Labor and Materials


1	Copper } Connection	3/4"	\$ 3.70
1	Curb } Cock Valve	3/4" in.	\$ 1.00
		F.S. & V.	
1	Service Box } Short 3 1/2 x 4 1/2		\$ 1.30
	Old returned } Long 4 1/2 x 5 1/2		
		Buff. or Rdway	
100	Ft. 6" in. } Copper Galv. Iron	Pipe at	\$ 2.20
		Cast Iron	
	Nipples	in. at	\$
1	Bushings	3/4" to 1/2" in. at	\$ 2.8
	Red'g Inc'g } Couplings	to in. at	\$
	Union	in. at	\$
	Meter	in. at	\$
	Lbs. Br. Stone	at	\$
	Lbs. Sand	at	\$
	Bags Cement	at	\$
	Paving Brick } Mack Red Asphalt	at	\$
	Lead Joints	at	\$
	Leadite Joints	at	\$
2	Hrs. Foreman	at 6 2 1/2	\$ 12.5
4	Hrs. Common Labor	at 5.0	\$ 20.0
4	Hrs. Common Labor	at 4.0 1/2	\$ 16.3
	Hrs. Mason	at	\$
	Hrs. Mason's Helper	at	\$
	Hrs. Compressor	at	\$
	Compensation Ins.		\$ 13
	Trucking		\$ 1.00
	Builders' Use of Water		\$

Total \$ 13.79

Labor and Material Report

1927

27-182 13 Oct 10, No 9 Smith st

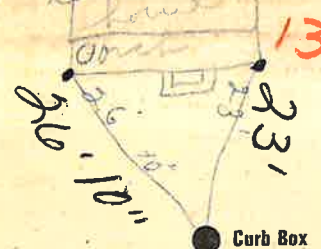

TAX ID # 302.16-6-21

4" Main Elev. of Main at tap 5'

Gate at 10 1/2' to main Gate at

3/4" copper Curb Box

Old Tap shut off