


Gate at ● 11' to main  
● Gate at 3/4" copper

Main  
Elev. of Main at tap  
Old connection to be dug up.

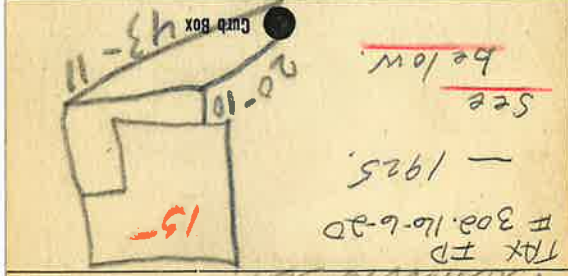

11  
Labor and Material Report  
1966