

LABOR AND MATERIALS


3/4" Copper Connection \$
 1 Curb { Cock Valve } 3/4" in. \$
 T. S. & V.
 1 Service Box { Short 3 1/2 x 4 1/2 } \$
 Old returned { Long 4 1/2 x 5 1/2 }
 Buff. or Rdway
 8 3/4 Ft. in. { Copper } Pipe at \$
 { Galv Iron }
 { Cast Iron }
 Nipples in. at \$
 Bushings to in. at \$
 Red'g Inc'g } Couplings to in. at \$
 Union in. at \$
 Meter in. at \$
 Lead Joints at \$
 Leadite Joints at \$
 Hrs. Foreman at \$
 Hrs. Chauffeur at \$
 Hrs. Tapper at \$
 Hrs. Labor at \$
 Hrs. Labor at \$
 Hrs. Compressor at \$
 Compensation Ins. \$
 Trucking \$
 Builders Use of Water \$
 \$
 \$
 \$
 \$

32 SOUTH

St.
Pl.
Ave. No. 32

Name of Owner

Labor and Mat'l. Report 1914

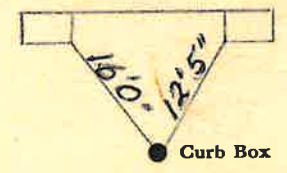

Main Elev. of Main at tap
 Gate at ● Gate at
 8" to main
 3/4" copper
 ● Curb Box