


South St. St. Pl. Ave. No. 197

Name of Owner

Tax ID # 309.12-13-1

Labor and Mat'l. Report 19

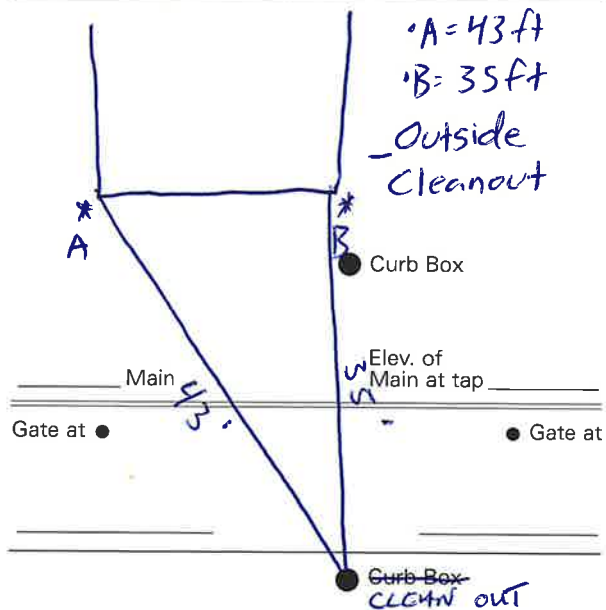

South


St. Pl. Ave. No. 197

Name of Owner

Labor and Mat'l. Report

NOV 2

19 25

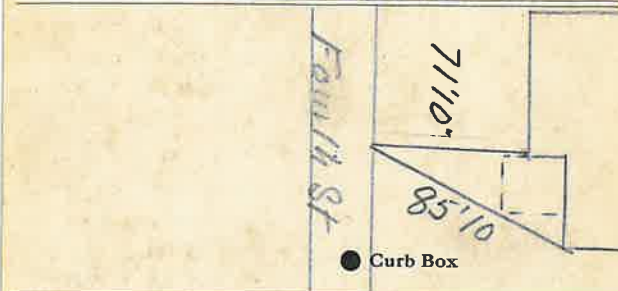

South St

Elev. of Main at tap

Main

Gate at

Gate at

13' to main
3/4" COPPER

Curb Box

LSM-5C-6-1-45

This tap from Fourth St

LABOR AND MATERIALS

_____ Copper } Connection _____ \$ _____
 _____ Lead }
 _____ Curb } Cock } _____ in. _____ \$ _____
 _____ Valve }
 _____ T.S. & V. }
 _____ Service box { Short 3-1/2 x 4-1/2 } _____ \$ _____
 _____ Old returned { Long 4-1/2 x 5-1/2 }
 _____ Ft. _____ in. { Copper } Pipe at _____ \$ _____
 _____ { G.I. }
 _____ { C.I. }
 _____ Nipples _____ in. at _____ \$ _____
 _____ Bushings _____ to _____ in. at _____ \$ _____
 _____ Red'g
 _____ Inc'g
 _____ Union _____ in. at _____ \$ _____
 _____ Meter _____ in. at _____ \$ _____
 _____ \$ _____
 _____ Compound Joints at _____ \$ _____
 _____ Maintenance Foreman _____ \$ _____
 _____ Hrs. Water Maint. Man - 1 at _____ \$ _____
 _____ Hrs. Water Maint. Man - 2 at _____ \$ _____
 _____ Hrs. Garage Foreman _____ at _____ \$ _____
 _____ Hrs. Labor _____ at _____ \$ _____
 _____ Hrs. Compressor at _____ \$ _____
 _____ \$ _____
 _____ Trucking _____ \$ _____
 _____ Pav't Patch _____ \$ _____
 _____ \$ _____
 _____ \$ _____
LABOR AND MATERIALS

/ _____ Copper } Connection 3/4 \$
 / _____ Lead }
 / _____ Curb } Clock } _____ in. \$
 / _____ Valve } T.S. & V. } 3/4
 / _____ Service box { Short 3 1/2 X 4 1/2 } \$
 / _____ Old returned { Long 4 1/2 X 5 1/2 }
 { Buff or Rdway }
13 Ft. 3/4 in. { Copper } Pipe at \$
 { Galv. Iron }
 { Cast Iron }
 Nipples in. at \$
 Bushings to in. at \$
 Red'g }
 Inc'g } Couplings to in. at \$
 Union in. at \$
 Meter in. at \$
 Lead Joints at \$
 Compound Joints at \$
 Hrs. Foreman at \$
 Hrs. Chauffeur at \$
 Hrs. Tapper at \$
 Hrs. Labor at \$
 Hrs. Labor at \$
 Hrs. Compressor at \$
 Compensation Ins. \$
 Trucking \$
 Builders Use of Water. \$
 \$
 \$
