

LABOR AND MATERIALS

1	Copper Lead	Connection	3/4	\$ 2.76
1	Curb	Cock Valve	3/4 in.	\$ 3.49
Same	Service box	Short 3 1/2 X 4 1/2		
	Old returned	Long 4 1/2 X 5 1/2		
		Buff or Rdway		
8	Ft. 3/4 in.	Copper Pipe at	38	\$ 3.04
		C.I.		
	Nipples	in. at		\$
	Bushings	to in. at		\$
	Red'g Inc'g	Coupl'gs to in. at		\$
	Union	in. at		\$
	Meter	in. at		\$
	Lead Joints at			\$
	Compound Joints at			\$
	Hrs. Water Maint. Man-1 at			\$
4	Hrs. Water Maint. Man-2 at	1.24		\$ 4.96
1.2	Hrs. Labor at	1.13		\$ 3.56
	Hrs. Labor at			\$
	Hrs. Compressor at			\$
	Compensation Ins. at	\$ 4.406 per C		\$ 82
	Trucking			\$ 1.00
	Pay't Patch			\$ 10.08
Tap by Gifford 7-24-53				\$
				\$
				\$
	O'head			\$
				\$ 39.71

29.63


66-53

South

St. ~~Pl~~
Ave. No. 200

Name of Owner
Lillian M. Hull

Labor and Mat'l. Report July 24 1953

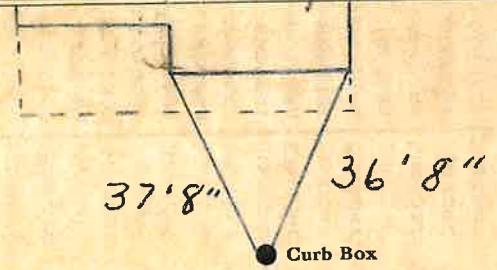

6" Main Elev. of Main at tap 5 1/2"

Gate at ● Gate at ●

8' to main
3/4" copper

● Curb Box

TAX ID # 309.12-11-52