

LABOR AND MATERIALS

1 Copper } Connection <sup>3/4"</sup> \$ \_\_\_\_\_  
 1 Lead }  
 1 Curb } Cock } 3/4 in. \$ \_\_\_\_\_  
           } Valve }  
           } T.S. & V. }  
 1 Service box { Short 3 1/2 x 4 1/2 }  
 Old returned { Long 4 1/2 x 5 1/2 } \$ \_\_\_\_\_  
                   { Buff or Rdway }  
 23 Ft. 3/4 in. { Copper } Pipe at \$ \_\_\_\_\_  
                   { G.I. }  
                   { C.I. }  
 Nipples in. at \$ \_\_\_\_\_  
 Bushings to in. at \$ \_\_\_\_\_  
 Red'g }  
 Inc'g } Coupl'gs to in. at \$ \_\_\_\_\_  
 Union in. at \$ \_\_\_\_\_  
 Meter in. at \$ \_\_\_\_\_  
 Lead Joints at \$ \_\_\_\_\_  
 Compound Joints at \$ \_\_\_\_\_  
 Maintenance Foreman \$ \_\_\_\_\_  
 Hrs. Water Maint. Man-1 at \$ \_\_\_\_\_  
 Hrs. Water Maint. Man-2 at \$ \_\_\_\_\_  
 Hrs. Garage Foreman at \$ \_\_\_\_\_  
 Hrs. Labor at \$ \_\_\_\_\_  
 Hrs. Compressor at \$ \_\_\_\_\_  
 Compensation Ins. at \$ \_\_\_\_\_ per C \$ \_\_\_\_\_  
 Trucking \$ \_\_\_\_\_  
 Pav't Patch \$ \_\_\_\_\_  
 Tap by Gissord & Co \$ \_\_\_\_\_  
                   7-9-57 \$ \_\_\_\_\_  
 O'head \$ \_\_\_\_\_  
 \$ \_\_\_\_\_

South


St. \_\_\_\_\_  
 Pl. \_\_\_\_\_  
 Ave. No. 203

Name of Owner

Sullivan

Labor and Mat'l. Report

July 9 19 57

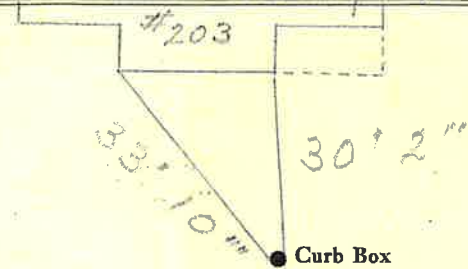

6" Main

Elev. of Main at tap 4 1/2'

Gate at •

• Gate at

23' to main

3/4" copper • Curb Box

TAX ID # 309.12-14-4