

LABOR AND MATERIALS

1	Copper Lead	Connection	$\frac{3}{4}$ "	\$	_____
1	Curb	Cock Valve T. S. & V.	$\frac{3}{4}$ " in.	\$	_____
1	Service box	} Short $3\frac{1}{2}$ x $4\frac{1}{2}$ Long $4\frac{1}{2}$ x $5\frac{1}{2}$ Buff or Rdway	}	\$	_____
	Old returned			\$	_____
10	Ft.	$\frac{3}{4}$ " in.	{ Copper G. I. C. I. }	Pipe at	\$ _____
	Nipples	in.	at	\$	_____
	Bushings	to	in.	at	\$ _____
1	Red'g Inc'g	$\frac{3}{4}$ " Male Adapter	Coupl'gs	to	in. at \$ _____
	Union	in.	at	\$	_____
	Meter	in.	at	\$	_____
	Lead Joints	at	\$	_____	
	Compound Joints	at	\$	_____	
	Maintenance Foreman	\$	_____		
	Hrs. Water Maint. Man-1	at	\$	_____	
	Hrs. Water Maint. Man-2	at	\$	_____	
	Hrs. Garage Foreman	at	\$	_____	
	Hrs. Labor	at	\$	_____	
	Hrs. Compressor	at	\$	_____	
	Compensation Ins.	at \$ _____ per C	\$	_____	
	Trucking	\$	_____		
	Pav't Patch	\$	_____		
	Tap by Gifford & Co.	7-10-57	\$	_____	
	O'head	\$	_____		
		\$	_____		

South


St. Pl. Ave. No. 204

Name of Owner

Lemery

Labor and Mat'l. Report

July 10 1957

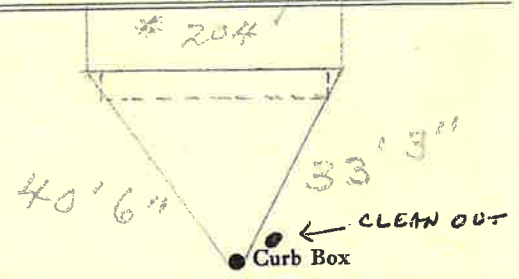

6" Main

Elev. of Main at tap $4\frac{1}{2}$ "

Gate at •

• Gate at

10' to main

$\frac{3}{4}$ " copper • Curb Box

TAX ID # 309.12-11-54