

LABOR AND MATERIALS

Copper	} Connection	_____	\$ _____	
Lead				
Curb	} Cock	_____ in.	\$ _____	
				} Valve
Service box	} Short 3½ x 4½	_____	\$ _____	
				} Long 4½ x 5½
Old returned	} Copper	_____	\$ _____	
				} G. I.
Ft.	in.	Pipe at	\$ _____	
Nipples	in.	at	\$ _____	
Bushings	to	in. at	\$ _____	
Red'g	} Coupl'gs	to _____ in.	at _____ \$ _____	
Inc'g				
Union	in.	at	\$ _____	
Meter	in.	at	\$ _____	
Lead Joints	at		\$ _____	
Compound Joints	at		\$ _____	
Maintenance Foreman			\$ _____	
Hrs. Water Maint. Man-1	at		\$ _____	
Hrs. Water Maint. Man-2	at		\$ _____	
Hrs. Garage Foreman	at		\$ _____	
Hrs. Labor	at		\$ _____	
Hrs. Compressor	at		\$ _____	
Compensation Ins.	at \$ _____ per C		\$ _____	
Trucking			\$ _____	
Pav't Patch			\$ _____	
<i>Measured in</i>				
<i>June 1965</i>				
O'head			\$ _____	
			\$ _____	


SOUTH

St. *205*
Pl. *147*
Ave. No. *147*

Name of Owner _____

TAX ID# *309.12-H-3*

Measured in
Labor and Mat'l. Report- *June 1965*

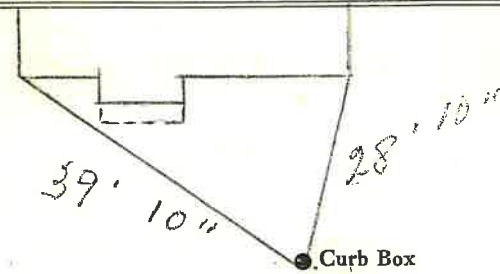

6\" Main Elev. of Main at tap *5'*

Gate at ● Gate at ●

● Curb Box