

LABOR AND MATERIALS

1	Copper Lead	Connection	3/4	\$ 1.35
+	Curb	Cock Valve F.S. & V.	3/4 in.	\$ 1.88
+	Service Box Old returned	} Short 3 1/2 x 4 1/2 Long 4 1/2 x 5 1/2 Buff. or Rdway		\$ 1.86
10	Ft. 3/4 in.		Copper Galv Iron Cast Iron	Pipe at 20 \$ 2.00
	Nipples		in. at	\$
	Bushings	to in. at	\$	
	Red'g Inc'g	Couplings	to in. at	\$
	Union	in. at	\$	
	Meter	in. at	\$	
	Lead Joints	at	\$	
	Leadite Joints	at	\$	
	Hrs. Foreman	at	\$	
6	Hrs. Chauffeur	at	\$ 4.13	
6	Hrs. Tapper	at	\$ 4.12	
+	Hrs. Labor	at	\$	
+	Hrs. Labor	at	\$	
	Hrs. Compressor	at	\$	
	Compensation Ins.		\$.26	
	Trucking		\$ 1.00	
	Builders Use of Water	Patch	\$ 9.00	
	Tapp by Hessel.			\$
				\$
				\$
				\$ 25.56

31 1942

South Str


St.
Pl.
Ave. No. 208

Name of Owner

Anderson

Labor and Mat'l. Report

July 15 1942

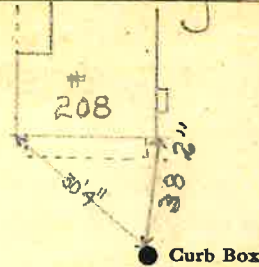

6 Main Elev. of Main at tap 5

Gate at ● ● Gate at

10' to main
3/4" copper

● Curb Box

TAX ID# 309.12-11-56