


Labor and Materials

1	Lead Connection	3/4	\$
1	Curb Cock		\$
1	Service Box	(Short 3 1/2 x 4 1/2)	\$
	Old returned	(Long 4 1/2 x 5 1/2 Buffalo)	\$
28	Ft. 3/4 in. C.P. Pipe at	Copper	\$
	Nipples	in. at	\$
	Bushings	to in. at	\$
1	Red's Coup	to in. at	\$
	Inc'g Coup	to in. at	\$
	Union	in. at	\$
	Meter	in. at	\$
	Cu. Yds. Br. Stone at		\$
	Cu. Yds. Sand at		\$
	Bags Cement at		\$
	Paving Brick	{ Mack Red Asphalt } at	\$
1.0	Hrs. Foreman at		\$
4.1	Hrs. Common Labor at		\$
	Hrs. Mason at		\$
	Hrs.	at	\$
	Hrs.	at	\$
old	Builders' Use of Water		\$
		at	\$
	Truck 100	at	\$
		at	\$
		at	\$
		at	\$
	Total	34.88	\$

Water and Material Report

209 South 19 25

3/4 tap at 149 South at

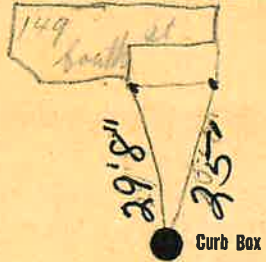

Main Elev. of Main at tap 42.11

Gate at ● 28' to main 3/4 inch copper ● Gate at

● Curb Box

TAX ID# 309.12.14-2