

LABOR AND MATERIALS

1	Copper	} Connection	\$	
1	Lead			
1	Curb	} $\frac{3}{4}$ in.	\$	
	Cock			
	Valve			
		T.S. & V.		
1	Service box	} { Short $3\frac{1}{2}$ x $4\frac{1}{2}$ Long $4\frac{1}{2}$ x $5\frac{1}{2}$ Buff or Rdway }	\$	
	Old returned			
29	Ft. $\frac{3}{4}$ in.	} { Copper G.I. G.I. }	\$	
	Nipples	in. at	\$	
	Bushings	to in. at	\$	
	Red'g	} Coupl'gs	to in. at	\$
	Inc'g			
	Union	in. at	\$	
	Meter	in. at	\$	
	Lead Joints	at	\$	
	Compound Joints	at	\$	
	Maintenance Foreman		\$	
	Hrs. Water Maint. Man-1	at	\$	
	Hrs. Water Maint. Man-2	at	\$	
	Hrs. Garage Foreman	at	\$	
	Hrs. Labor-	at	\$	
	Hrs. Compressor	at	\$	
	Compensation Ins.	at \$ per C	\$	
	Trucking		\$	
	Pav't Patch		\$	
			\$	
			\$	
	O'head		\$	
			\$	

SOUTH


St. ~~Pl.~~ Ave. No. 211

Name of Owner

HARRY GATES

Labor and Mat'l. Report

AUG. 17 1934

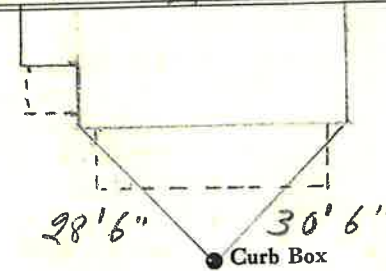

6" Main

Elev. of Main at tap $4\frac{1}{2}$

Gate at • Gate at

29' to CORY 1965.
 $\frac{3}{4}$ " COPPER

• Curb Box
BOX IN TREE STOP WASTE
CURB COCK SHUTS OFF TO
THE LEFT

TAX ID# 309.12-14-1