


LABOR AND MATERIALS

1	Copper	Connection	3/4"	\$	
1	Lead	Cock	3/4 in. Oriseal	\$	
1	Curb	Valve	3/4 in.	\$	
		T.S. & V.			
1	Service box	Short 3 1/2 x 4 1/2		\$	
	Old returned	Long 4 1/2 x 5 1/2		\$	
		Buff or Rdway		\$	
9	Ft. 3/4 in.	Copper	Pipe at	\$	
		G.I.		\$	
		G.I.		\$	
	Nipples	in. at		\$	
	Bushings	to in. at		\$	
	Red'g	Coupl'gs	to in. at	\$	
	Inc'g			\$	
	Union	in. at		\$	
	Meter	in. at		\$	
	Lead Joints	at		\$	
	Compound Joints	at		\$	
	Maintenance Foreman			\$	
	Hrs. Water Maint. Man-1	at		\$	
	Hrs. Water Maint. Man-2	at		\$	
	Hrs. Garage Foreman	at		\$	
	Hrs. Labor	at		\$	
	Hrs. Compressor	at		\$	
	Compensation Ins. at \$	per C		\$	
	Trucking			\$	
	Pav't Patch			\$	
	Tap by Gifford & Co.			\$	
				\$	
				\$	
				\$	
	O'head			\$	
				\$	

St. South
 -Pt. 214
 Ave. No. 214

Name of Owner
Mrs. Harry Tidmarsh.

Labor and Mat'l. Report Oct. 17 1967

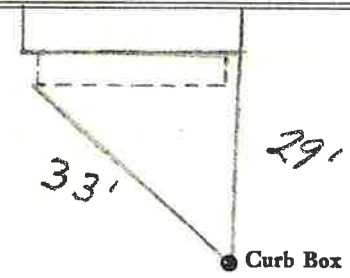

6" Main Elev. of Main at tap 4'

Gate at • Gate at •

9' to main

3/4" copper • Curb Box

ORISEAL

TAX ID # 309.12-11-58