

LABOR AND MATERIALS

1 Copper Lead	Connection $\frac{3}{4}$			\$ 1.23
1 Curb	Cock Valve T. S. & V. $\frac{3}{4}$ in.			\$ 1.68
1 Service Box	Old returned { Short $3\frac{1}{2} \times 4\frac{1}{2}$ Long $4\frac{1}{2} \times 5\frac{1}{2}$ Buff. or Rdway }			\$ 1.75
9 Ft. $\frac{3}{4}$ in.		Copper Galv Iron Cast Iron	Pipe at	\$ 1.35
Nipples	in. at			\$
Bushings	to in. at			\$
Red'g Inc'g	Couplings to in. at			\$
Union	in. at			\$
Meter	in. at			\$
Lead Joints	at			\$
Leadite Joints	at			\$
Hrs. Foreman	at			\$
2 Hrs. Chauffeur	at .62 hr			\$ 1.25
4 Hrs. Tapper	at			\$ 2.50
Hrs. Labor	at			\$
5 Hrs. Labor	at .45			\$ 2.25
2 Hrs. Compressor	at .87 hr			\$ 1.75
Compensation Ins.				\$.19
Trucking				\$ 1.00
Builders Use of Water				\$
Tap by Messell				\$
Pitch				\$ 9.00
				\$
				\$ 23.95

41 - 1938

St.

Pl.

South


Ave. No. 216

Name of Owner

Lize

Labor and Mat'l. Report

July 12, 1938

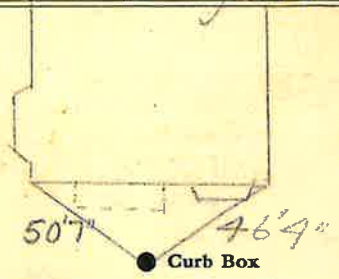

6 Main

Elev. of Main at tap 4

Gate at ●

● Gate at

9' to main
 $\frac{3}{4}$ " copper

● Curb Box

TAX ID # 309.12-11-59

old shut off