

LABOR AND MATERIALS

1	Copper Lead	Connection	3/4"	\$
1	Curb	Cock Valve T.S. & V.	3/4 in.	\$
1	Service box Old returned	Short 3 1/2 x 4 1/2 Long 4 1/2 x 5 1/2 Buff or Rdway		\$
28'-30'	3/4 in.	Copper G.I. C.I.	Pipe at	\$
	Nipples	in. at		\$
	Bushings	to in. at		\$
	Red'g Inc'g	Coupl'gs. to in. at		\$
	Union	in. at		\$
	Meter	in. at		\$
	Lead Joints	at		\$
	Compound Joints	at		\$
	Maintenance Foreman			\$
	Hrs. Water Maint. Man-1	at		\$
	Hrs. Water Maint. Man-2	at		\$
	Hrs. Garage Foreman	at		\$
	Hrs. Labor	at		\$
	Hrs. Compressor	at		\$
	Compensation Ins. at \$	per C		\$
	Trucking			\$
	Pav't Patch			\$
	O'head			\$


N.W. Corner Stewart Ave. And.

St. Pl. Ave. No. **221**  
**South**

Name of Owner  
Ed. O'Carner

Measured in 3-18-66.

Labor and Mat'l. Report AUG 21 1928.

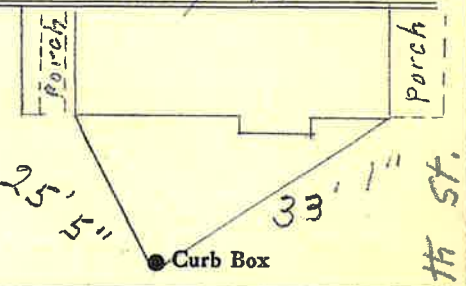

Stewart Ave  
6" Main Elev. of Main at tap 5'

Gate at ● Gate at

28-30' (?) to MAIN

3/4" copper ● Curb Box

Tap on Stewart Ave

TAX ID # 309.12-15-1