

LABOR AND MATERIALS


Copper	} Connection		\$		
Lead					
Curb	} Cock Valve T.S. & V.	} in.	\$		
Service box	} Short 3 1/2 x 4 1/2 Long 4 1/2 x 5 1/2 Buff or Rdway		\$		
Old returned					
13 Ft. 5 in.	} Copper G.I. C.I.	} Pipe at	\$		
Nipples	in. at		\$		
Bushings	to in. at		\$		
Red'g	} Coupl'gs	to in. at	\$		
Inc'g					
Union	in. at		\$		
Meter	in. at		\$		
Lead Joints	at		\$		
Compound Joints	at		\$		
Maintenance Foreman			\$		
Hrs. Water Maint. Man-1	at		\$		
Hrs. Water Maint. Man-2	at		\$		
Hrs. Garage Foreman	at		\$		
Hrs. Labor	at		\$		
Hrs. Compressor	at		\$		
Compensation Ins. at \$	per C		\$		
Trucking			\$		
Pav't Patch			\$		
<i>Remeasured by Peck & St. John.</i>					
O'head	5-10-71.		\$		

South

St. Pl. Ave. No. 224

Name of Owner

Remeasured Labor and Mat'l. Report May, 10 19 71

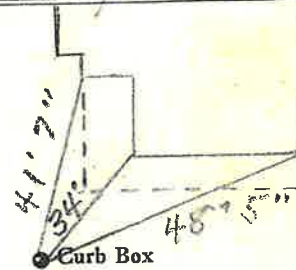

6" Main Elev. of Main at tap 4 FT 3"

Gate at • Gate at

13' 5" to main

Copper • Curb Box

TAX ID# 309.12-11-62