

Labor and Materials


1	Copper } Connection.....	\$ 2.60
	Lead }	
1	Curb } Cock Valve }	\$ 2.27
	T.S. & V. }	
1	Service Box } Short 3/4 x 1/2 }	\$ 1.38
	Old returned } Long 1/2 x 3/4 }	
		Buff. or Rdway }
27	Ft. } in. } Copper Galv. Iron } Pipe at.....	\$ 4.66
		Cast Iron }
	Nipples.....	in. at..... \$
	Bushings.....	to..... in. at..... \$
	Red'g } Couplings.....	to..... in. at..... \$
	Inc'g }	
	Union.....	in. at..... \$
	Meter.....	in. at..... \$
	Lbs. Br. Stone at.....	\$
	Lbs. Sand at.....	\$
	Bags Cement at.....	\$
	Paving Brick } Mack } at.....	\$
		Red }
		Asphalt }
	Lead Joints at.....	\$
	Leadite Joints at.....	\$
13	Hrs. Foreman at.....	\$ 9.13
30	Hrs. Common Labor at.....	\$ 13.50
	Hrs. Common Labor at.....	\$
	Hrs. Mason at.....	\$
	Hrs. Mason's Helper at.....	\$
4	Hrs. Compressor at \$7.14.....	\$ 3.50
	Compensation Ins.....	\$.66
	Trucking.....	\$ 1.-
	Builders' Use of Water Patel.....	\$ 73.-
Total		\$ 62.70

Labor and Material Report

225 SOUTH

22 1931

225 S

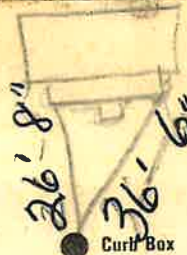

TAX ID # 309.16-1-3

6 Main

Elev of Main at tap 51

Gate at

37' to MAIN
3/4" copper

Gate at

Curb Box

water
old trap shot

REPAIR ON LINE
water 2/20/07

Wasted a curb stop for
repair. Received a small
shock from water line during
repair.