


Labor and Materials

Copper	Connection	\$	2.60	
Curb	Cock	} in.....	\$	2.27	
	Water				
	P. S. & V.				
Service Box	Short 3/4x1 1/2	}	\$	1.38	
Old returned	Long 1/2x3/4				
	Build. or Rdway				
6 Ft.	Copper	} Pipe at.....	\$	8.28	
	Galv. Iron				
	Cast Iron				
Nipples	in. at.....		\$		
Bushings	to..... in. at.....		\$		
Red'g	} Couplings..... to..... in. at.....		\$		
Inc'g					
Union	in. at.....		\$		
Meter	in. at.....		\$		
Lbs. Br. Stone	at.....		\$		
Lbs. Sand	at.....		\$		
Bags Cement	at.....		\$		
Paving Brick	} at.....		\$		
					Mack
					Red Asphalt
Lead Joints	at.....		\$		
Leadite Joints	at.....		\$		
14 Hrs.	Foreman at.....		\$	9.75	
1 Hrs.	Common Labor at.....	50	\$	50	
35 Hrs.	Common Labor at.....	45	\$	15.75	
Hrs.	Mason at.....		\$		
Hrs.	Mason's Helper at.....		\$		
3 Hrs.	Compressor at.....	1.50	\$	4.50	
Compensation Ins.		\$	76	
Trucking		\$	1-	
Builders' Use of Water	Park		\$	23-	
Total				\$ 68.79	

31-52 227 SOUTH
Labor and Material Report 7 1930

227 South St

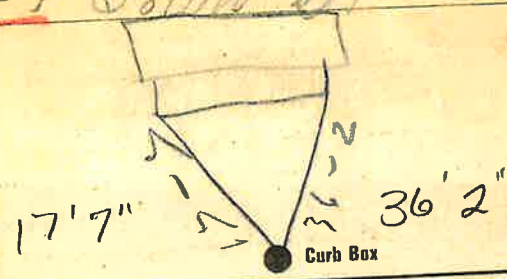

6 Main Elev of Main at tap
 Gate at 46' (?) to main Gate at

Copper ● Curb Box

5/11 Tap shut off

TAX ID# 309.116-1-2