


LABOR AND MATERIALS

Copper } Connection _____ \$
 Lead }
 Curb } Cock _____ in. \$
 } Valve _____
 } T. S. & V. }
 Service box { Short 3½ x 4½ }
 Old returned { Long 4½ x 5½ } _____ \$
 { Buff or Rdway }
 Ft. _____ in. { Copper } Pipe at _____ \$
 { G. I. }
 { C. I. }
 Nipples _____ in. at _____ \$
 Bushings _____ to _____ in. at _____ \$
 Red'g }
 Inc'g } Coupl'gs _____ to _____ in. at _____ \$
 Union _____ in. at _____ \$
 Meter _____ in. at _____ \$
 Lead Joints at _____ \$
 Compound Joints at _____ \$
 Maintenance Foreman _____ \$
 Hrs. Water Maint. Man—1 at _____ \$
 Hrs. Water Maint. Man—2 at _____ \$
 Hrs. Garage Foreman _____ at _____ \$
 Hrs. Labor— _____ at _____ \$
 Hrs. Compressor at _____ \$
 Compensation Ins. at \$ _____ per C _____ \$
 Trucking _____ \$
 Pav't Patch _____ \$
 _____ \$
 _____ \$
 _____ \$
 O'head _____ \$
 _____ \$

St. _____
 Pl. _____
SOUTH ST Ave. No. **228**
 Name of Owner _____
 TAX ID # 309.12-11-64

Labor and Mat'l. Report _____ 19 **79**

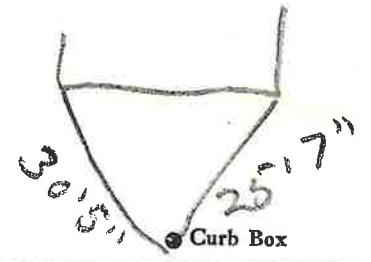

6 Main _____ Elev. of Main at tap _____
 Gate at • _____ Gate at _____

• Curb Box