

### LABOR AND MATERIALS


1. Copper / Lead	Connection	3/4	\$ 2.87
1. Curb	Cock Valve T. S. & V.	3/4 in.	\$ 3.62
1. Service box Old returned	Short 3/4 X 4 1/2 Long 4 1/2 X 5 1/2 Buffer Rdway		\$ 4.68
31 Ft. 3/4 in.	Copper C.I. Pipe at	32	\$ 9.92
Nipples	in. at		\$
Bushings	to in. at		\$
Inc'g Coupl'gs	to in. at		\$
Union	in. at		\$
Meter	in. at		\$
Lead Joints at			\$
Compound Joints at			\$
13 Hrs. Water Maint. Man-1 at			\$
25 Hrs. Water Maint. Man-2 at	1.02		\$ 13.26
25 Hrs. Labor - at	91		\$ 22.75
3 Hrs. Labor - at			\$
3 Hrs. Compressor at	1.20		\$ 3.60
Compensation Ins. at \$ 2.18 per C			\$ 7.9
Trucking			\$ 3.00
Pav't Patch			\$ 14.85
Tap by 1 1/2" pipe			\$
O'head			\$
			\$ 78.34

104

St. PI. 7  
Ave. No. 229

Name of Owner Johnson

Labor and Mat'l. Report Sept 27 1949

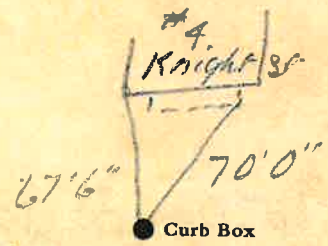

6 Main Elev. of Main at tap 6

Gate at ● Gate at ●

31' to MAIN  
3/4" COPPER

● Curb Box

TAX ID# 309.16-1-1