

LABOR AND MATERIALS

1	Copper	{ Connection	3/4"	\$ 3.04
1	Lead			
1	Curb	{ Cock Valve T. S. & V. }	3/4 in.	\$ 3.54
1	Service box	{ Short 3 1/2 x 4 1/2 }		
	Old returned	{ Long 4 1/2 x 5 1/2 }		\$ 4.70
15	Ft.	{ Buff or Rdway }		
	3/4" in.	{ Copper C.I. C.I. }	Pipe at 35	\$ 5.25
	Nipples	in. at		\$
	Bushings	to in. at		\$
	Red'g	{ Coupl'gs to in. at		\$
	Inc'g			\$
	Union	in. at		\$
	Meter	in. at		\$
	Lead Joints at			\$
	Compound Joints at			\$
2	Hrs. Water Maint. Man	1 at	1.33	\$ 2.67
7	Hrs. Water Maint. Man	2 at	1.13	\$ 7.91
	Hrs. Labor	at		\$
	Hrs. Labor	at		\$
	Hrs. Compressor at			\$
	Compensation Ins. at \$	per C.	28	\$
	Trucking			\$ 1.10
	Pav't Patch			\$ 14.85
				\$
				\$
	O'head			\$
				\$ 43.24

Tap made by Gifford
Oct. 10, 1951

South


St. Pl. Ave. No. 238

Name of Owner

Rando

Labor and Mat'l. Report

Oct. 10, 1951

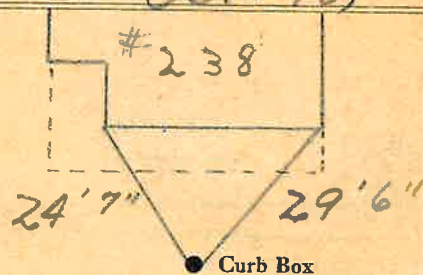

6" Main

Elev. of Main at tap 6'

Gate at ●

● Gate at

15' to MAIN
3/4" copper

● Curb Box

TAX ID # 309.16-3-12