


LABOR AND MATERIALS

1	Copper Lead	Connection	3/4"	\$
1	Curb	Cook Valve T.S. & V.	3/4" Oriseal	\$
1	Service box Old returned	Short 3 1/2 x 4 1/2 Long 4 1/2 x 5 1/2 Buff or Rdway		\$
11	Ft. 3/4 in.	Copper G.I. C.I.	Pipe at	\$
	Nipples	in. at		\$
	Bushings	to in. at		\$
	Red'g Inc'g	Coupl'gs. to in. at		\$
	Union	in. at		\$
	Meter	in. at		\$
	Lead Joints	at		\$
	Compound Joints	at		\$
	Maintenance Foreman			\$
	Hrs. Water Maint. Man-1	at		\$
	Hrs. Water Maint. Man-2	at		\$
	Hrs. Garage Foreman	at		\$
	Hrs. Labor	at		\$
	Hrs. Compressor	at		\$
	Compensation Ins. at \$	per C		\$
	Trucking			\$
	Pav't Patch			\$
	Tap by Gifford + Bureau			\$
		11-25-66.		\$
	O'head			\$
	Leak in old service,			\$

St. South
 -Pt. Ave. No. 240

Name of Owner
Walter Turner

Labor and Mat'l. Report Nov. 25 1966.

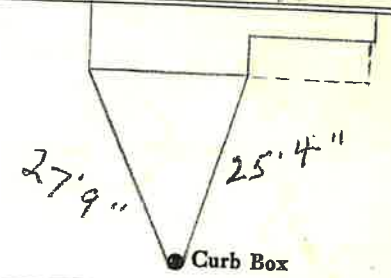

6" Main Elev. of Main at tap 4 1/2'

Gate at ● Gate at ●

11' to main

3/4" copper ● Curb Box

ORISEAL

TAX ID# 309.16-3-14